

30 | 29

31 | 32 Found Brick Bat + few Pieces of fire  
 4" o-150m. Soil = 3" long 8" deep / lime stone  
 3" x 4" x 7" / limestone 3" x 3" x 6" at depth  
 Of 16" 4 small pieces of lat. at top of  
 All evidences lowered and set C.M.

Ties from X nails

84.7 S.E. from wood Post in Ho. Fence  
 53.8 SW from Power Pole  
 88.9 NW from wood Fence Post  
 56.2 NW from Guy Pole  
 56.75 NE. from Nook in 24' C.M.P.  
 78.35 NE. from Top wood Post



Found 9-25-39

OK 7-23-69 Cue

CM 18" deep

Keiron Pin

over Gun 5" deep

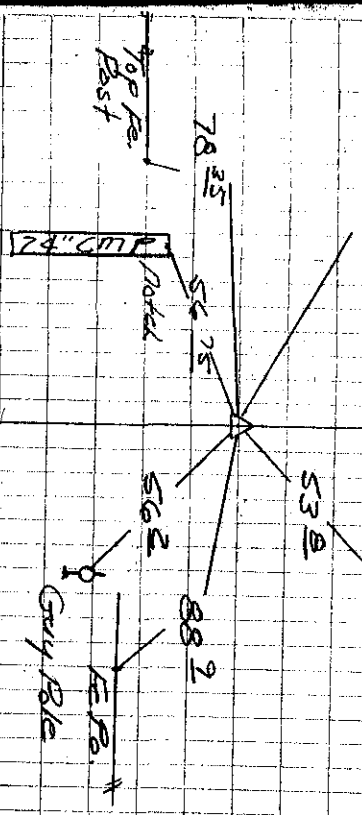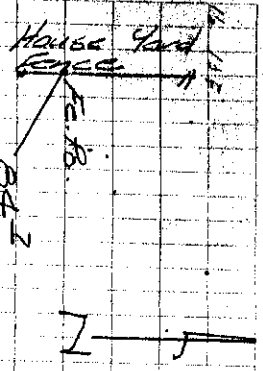

Found 5/29/63

Caney - Candy

Slope Chain

OK 7-1-65

Richard's Cherry SAC

Ties OK

10-22-75

Bernard - Kearnes, Kainey, Ramsey, Bulke

Rainbird

7/24/86 Found 1/2" bolt over cm 24'

deep retid. Keairnes, Mackey, Campbell

Sharp, Babic