

6 5 NE cor. sec. 2 - TREN-RELLY
7 8

Found laths, 12" spraked wheel, angle iron
15" long, old bricks, 2" gas pipe 4' long,
dry battery, old axe, 1" gas pipe 3' long,
and bricks, at a depth of from 1' to 4'
lowered evidence and set C.M.


Ties from X-splts in cor. p.

64 1/2 SW of corner post
45 1/2 NW Power pole
48 1/2 NE Corner post
49 1/2 SE of road
172.5 SE of SE cor. of house

6-15-71 Reset 1" Iron P. in From Tost.
Ties. 10" deep.
Note: old lath Ties stick Secure
See Topog book SW-2025
Krusse, Ehlman, Feinnes, Petersen

3-73

3 28 F

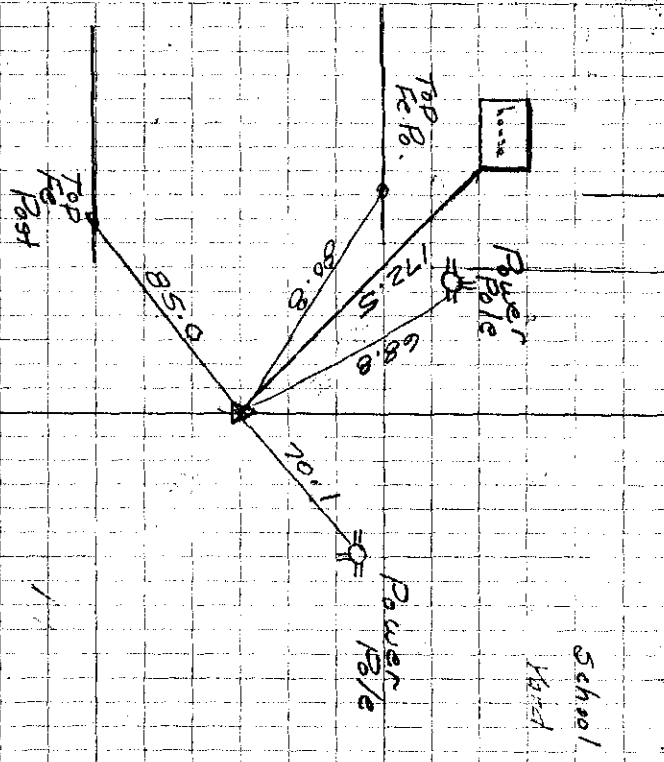

Apr. 25 1939
OK 2/23/60
Found 2-28-60

7:30-8:00 Checked from N. & S. 1/4 Cor. S.
Also from W. 1/4 Cor. which is 2690'
This cor. is set 8.7' west of. 2690'
Measure by Co. Engr. William Stone
Cue. Wood. Swanson. Rupp. Brownaw
Eggers C.M. 9" deep