

4-3 6-20-40-Unable to find lines
D.I. not dig.

RAIL SET BY HIGHWAY COMMISSION. OCT. 1969

TIES

- 44.7 S.W. OF 8" OAK
- 78.0 N.W. OF 12" OAK
- 6.3 NORTH OF BRACE POST FEELER SOUTH
- 10.1 EAST OF BRACE POST FEELER WEST
- 77.9 S.E. OF 14" TWIN OAK


33

Found red rock 6" dia
at surface of ground. lowered
and set C.M.


Ties from "X" nails in posts "plumb chained"

- 3.4 S.E. from Cor. B.
- 2.4 S.W. from Cor. B.
- 3.2 S.W. from Power Pole
- 4.7 N.E. from Brace Post
- C.S S.E. from Cor. B.

31-7

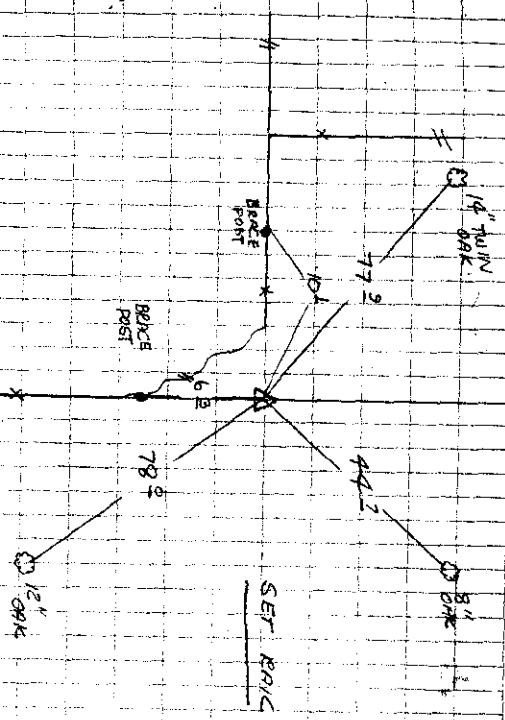

FOUND CORN. MARK, OCTOBER 1964.

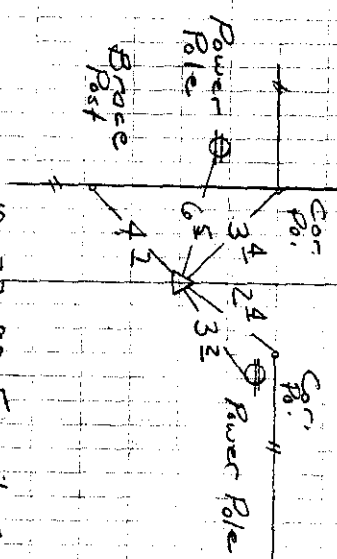

10-22-90 Found C.M.
0.2' deep. Ties from
Towd Reg. # 4129