

15+14


E 1/4 Cor of Sec. 15-84-40

Dug 3'x3'x3' hole and found 1 rock  
7"x6"x4" at a depth of 28" lowered  
same to a depth of 4' and set CM

Ties from X spikes in cor post  
46.9 NE from 3rd post S  
30.2 E from telephone pole  
36.4 WNW from fe line N/S

15+14

7-45-F

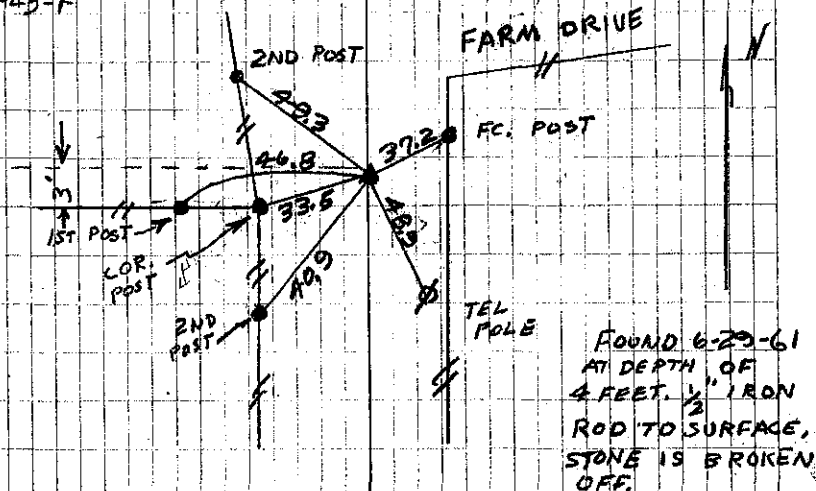

10/15

N 1/4 Cor of 15-84-40

Established Corner 7-20-39  
Set CM (Dug 8x8x4" hole)

Ties from "X" nails

30.9 S. from Cor. Po.  
64.0 S.W. from Power Pole  
32.4 N.E. from fence post  
33.65 N.W. from fence post

10/15

8-24 E  
7-415