

34.35

6-19-40 found rotting wood
state 18" long, 5 pieces of drift
lock 6" x 10" x 10" on edge - 12" deep.
Lowered and set C.M.

ties from resp's in car post
1.0 S.E. from car post

~~29~~ 9-18-39 found knot 14"
x 17" nail - 3 1/2' deep. Remains of
rotted wood stake. 1 dry cell
battery. Handle of gal. pail. 3' deep
lowered and set C.M.

Ties from X nails


820 S on Section line also R Nail
102.5 S.W. of Power Pole
40.8 S.E. of Yellow Steel Rod
24.1 S. of Yellow Steel Rod on S
56.0 S.W. of Yellow Steel post
62.6 S.W. of Central Tele. Steel Rod

30-41

N


Found 6-19-40

69

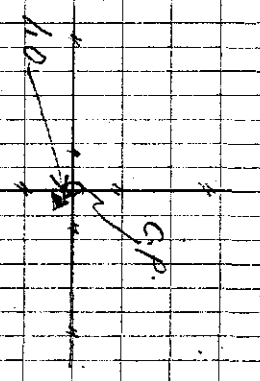

12-44

Found 9-18-39

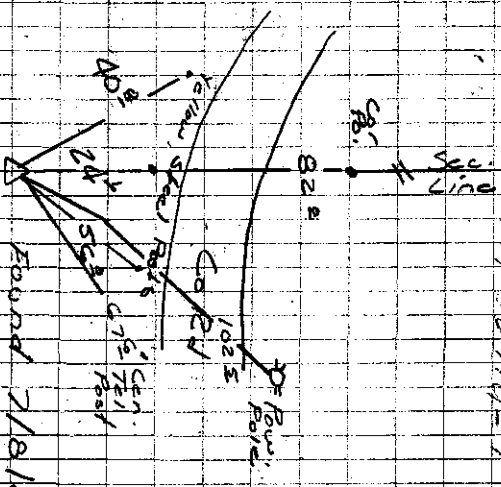

010 4-29-94 Ties OK

Found 7/8/41
C.M. 12" deep clay.
Benny. Keaines