

10-11

Established corner by ties  
from Bk# P#  
Set C.M.


Ties from X spikes in cor posts  
60.5 S.E. from 18" Walnut tree  
33.3 E " " Corner Post  
34.0 ENE " " 12" Locust tree  
31.5 W " " Cor Post

~~37.0 S.W. " " 4" gate post~~  
May 31, 1955 Gov. Marker 20" Wood hub  
to surface

3 DU9 2x5x18 Date 9/19-39  
10 Found brick bats, 1 brick 4"x6"x10"  
1" x 24" iron stake at a depth of 4'  
Lowered and set C.M.


Ties from "X" nails  
12.95 S.E. from fence post  
9.40 S.W. from fence post  
41.90 N.W. from Power Pole  
58.70 N.E. from East Gate Post

33-17-F (E)  
Established 8-13-40  
OK July 13, 1944  
OK May 31, 1955

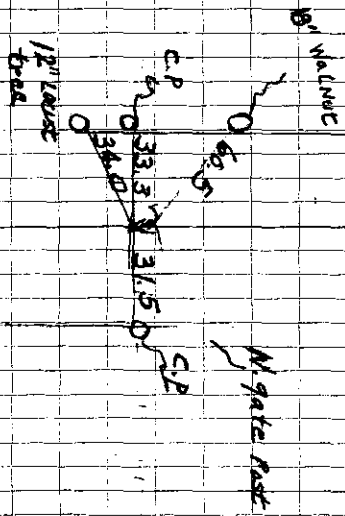

33-18-F  
13-31-S

Found 8-13-40

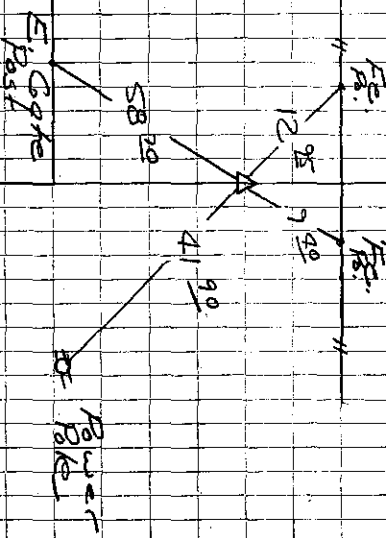

10/28/91 Set by  
ELS # 4129  
Iron Pin