

10-11

Established corner by ties
from BK# P#
Set C.M.

Ties from X spikes in cor posts
60.5 S.E. from 18" Walnut tree
33.3 E " " Corner Post
34.0 E.W.E. " " 12" Locust tree
31.5 W " " Cor Post


~~37.0 S.W. " " 4 gate post~~
May 31, 1955 Gov. Marker 20" Wood hub
to surface

3 DU9 2x5x18 Date 9-19-39
10 Found brick bats, 1 brick 4"x6"x10"
1" x 24" iron stake at a depth of 4'
Lowered and set C.M.

Ties from "X" nails
12.95 S.E. from fence post
9.40 S.W. from fence post
41.90 N.W. from Power Pole
58.70 N.E. from East Gate Post


33-17-E (E)

Established 8-13-40
OK July 13, 1944
OK May 31, 1955

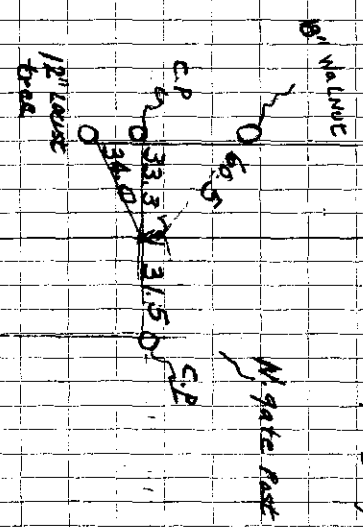

33-18-F
13-31-S

Found 8-13-40

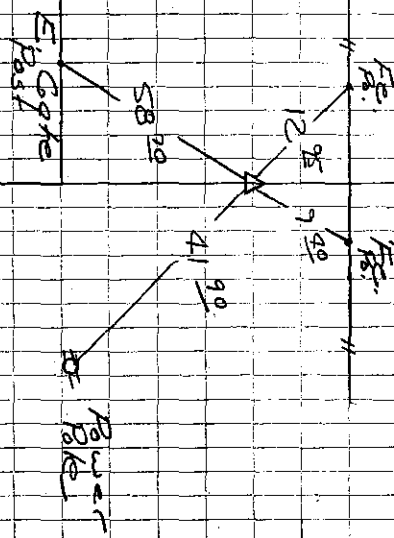

101228191 Set by
E.L.S. # 4129
Iron Pin