


32 Center Sec. 32

Oct 1 1982 Established from evidence by H. Dale Wright Co. Engineer

33.0 Ties from X nails North from Power Pole

P.I. info. in Center Sec 32

P.I. Approx 921' East of Center of Sec 32 @ Site Behrendt Farm set by instruction of H. Dale Wright Oct 1 1982

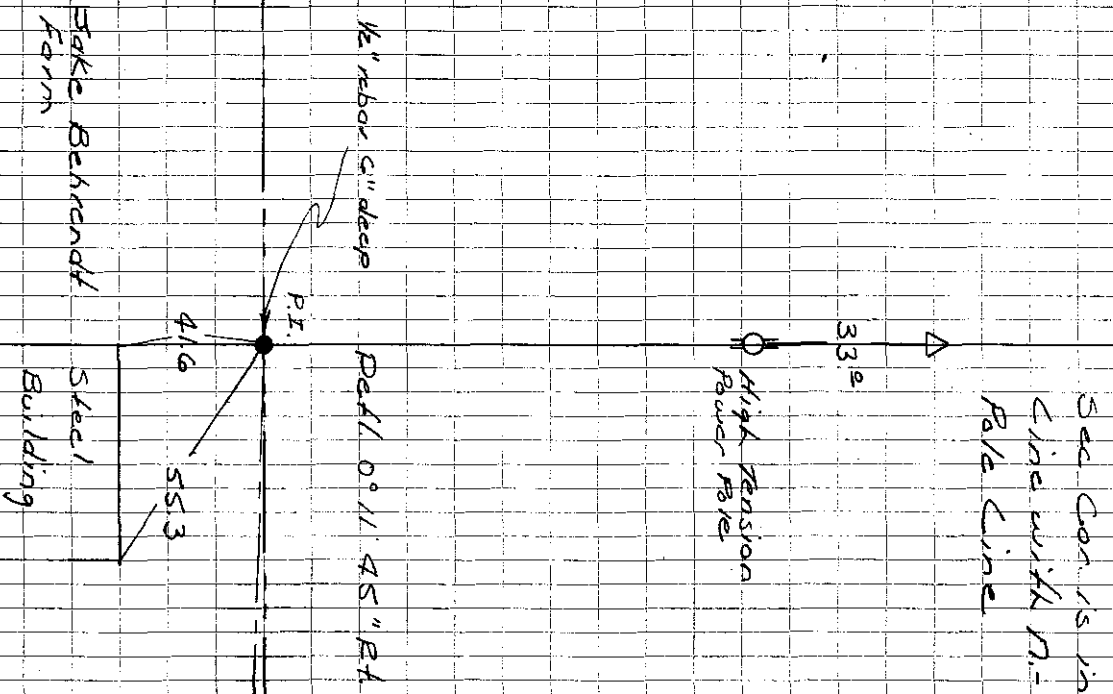

Sec Con. is in line with N-5 Pole line

33.0 High Tension Power Pole

1/2" rebar 6" deep P.I. 0.11 45" Pt

Site Behrendt Farm

Steel Building