

3 p.

Found by ties from BK #11 P# 9
Track 8'x10'x14' small food chopper grass' crickets
at a depth 16" lowered and set on.


Ties from X' nails
4485 S.E. from Fence Post
3130 E. from Power Pole
4162 N.E. from Fence Post
3545 W. from Cor. Post

34

3 Dug 4'x4'x1/4' hole in line of fence
from S. Did not find corner. Farmer says
this corner is gone. Road was opened 2 yrs
ago. Says this part was all back and very
rough

Ties from X' nails
6127 N.E. from Fe. P.
4350 N.E. from Brace Post
4037 N. from Corner Post
4070 N.W. from Brace Post
700 S. of E. of County Road

Found May 30, 1955

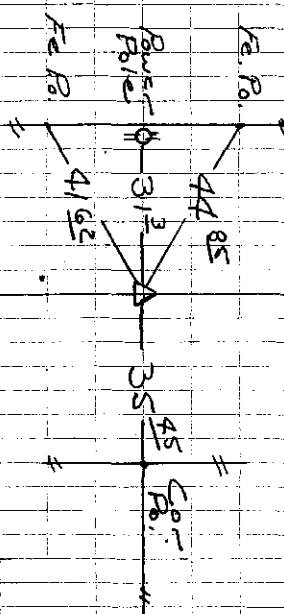

Found 5-28-40
10/23/91 Found Iron P.
0.3' deep Ties by
R.L.S. # 4129

1336-S

Dug 9-19-39
10/28/91 Iron Pin set by Sundquist Engr
Ties submitted by E.L.S. # 4129

County Road

