Dug 12-19-39
Redug 3-21-41

18/17 Using McHenrys Bk* 63 Page* 66 as reference dug hole in line of east & west fence & 35.6 West of Cottonwood row & 20.0 East of willow, at this point found two pieces of brick. Lowered old evidence & Set C.M. about 8" below road.

Note: this corner is double the 1/4 1/4 distance from south

ties from x-spks

34.9 WSW of cor post (OLD TIES)
19.2 East of willow
65.6 NE of 20" cottonwood

18 Found 10" long notched pine stake pointed at a depth of 20. Stake at Engineers office says this 1/4 cor is about 9.0 N. of cemetery fence which checks with distance of stake found. Also stake is in line of E-W fence N. Lowered and set C.M.

ties:
54.3 S. from steel cor post
83.2 SW. " " power pole
199.0 ESE " " " " "
69.5 NE " " Marker (Name Larson
8.5 N " " W. gate post
26.4 NW " " Marker (Lindberg
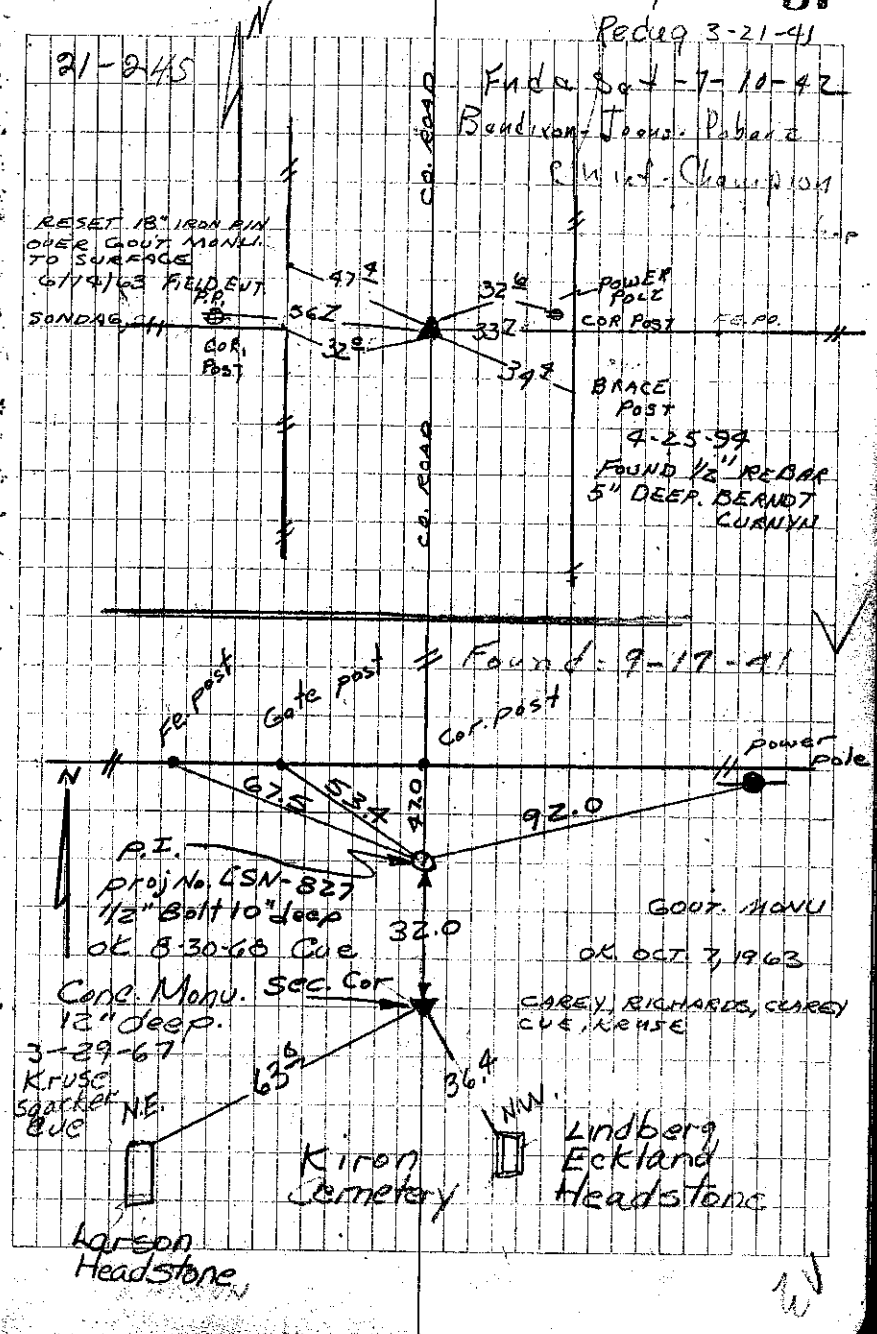
ties from Markers taken from Base