4-13

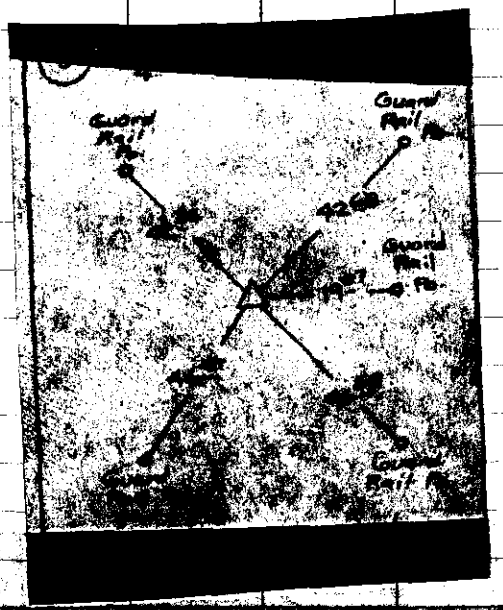

5-1-68

Guard rail Po.

Guardrail Po.

42.26

42.68

19.07

Guard rail Po.

46.47

46.58

Guardrail Po.

Guard rail po.

 

14 Four

7 Pieces

fitted

and

ders of

this end

ties from

9.6 S.

32.5 S.

33.7 N.

33.6 N.

Found 9-26-10
5-1-68 Found lead plug in pavement

N

COR POST

F. POST

F. POST

POWER POLE

49.9

63.0

42

RETIED 6-25-63.
IRON ON TOP MON
3" BELOW SURF. ROAD
CUE, MULLEN

SET LEAD PLUG 6-9-64
CUREY-REUSE-CUE

48.3

TEL. POLE

Witness Cor is 35.2 N. of the Cor under N. fence